


REV.	DATE	ITEM
01	03/28/25	BID ADD. NO.01
02	03/28/25	BID ADD. NO.02

NOTICE
THESE DRAWINGS ARE BASED ON CONSTRUCTION DRAWINGS NOT PREPARED BY BBS ARCHITECTS, LANDSCAPE ARCHITECTS AND ENGINEERS. THE DRAWINGS DO NOT SHOW CONDITIONS AS CONSTRUCTED AT THE TIME. ALL EXISTING CONDITIONS SHOWN ARE FOR INFORMATION ONLY. CONDITIONS NOT SHOWN HAVE NOT BEEN BUILT AND DETAILED PER THE ORIGINAL DOCUMENTS OR PER THE OWNER'S INFORMATION.

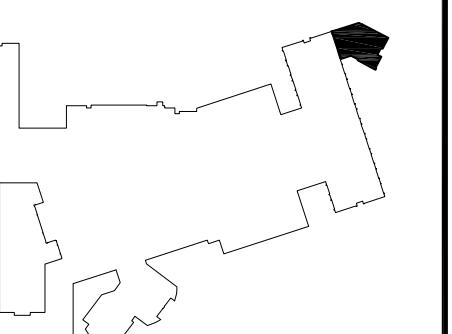


KEY PLAN
NOT TO SCALE

GARDEN CITY UNION FREE SCHOOL DISTRICT
ADDITIONS AND ALTERATIONS
GARDEN CITY HIGH SCHOOL
GARDEN CITY, NASSAU COUNTY, NEW YORK
FIRST FLOOR FINISH PLANS
AND GENERAL NOTES


PROJECT
DWG TITLE
DRAWING BY: WCA
CHECK BY: GWS

NOTICE
THE DRAWING PREPARED FOR THE SPECIFIC PROJECT INDICATED IN THIS DRAWING ARE THE PROPERTY OF BBS ARCHITECTS, LANDSCAPE ARCHITECTS AND ENGINEERS. PC INFORMATION CONTAINED HEREIN IS PROPRIETARY AND CONFIDENTIAL. THIS PROJECT IS PROMPTED, ANY ALTERATION OR REPRODUCTION OF THE DRAWING IS PROHIBITED WITHOUT THE WRITTEN CONSENT OF THE ARCHITECT OR ENGINEER.

BBS
ARCHITECTS
LANDSCAPE ARCHITECTS
ENGINEERS
244 EAST MAIN STREET
POTCHEFEST
NEW YORK 11772
T. 631.475.0361
F. 631.475.7655
www.bbsarchitecture.com

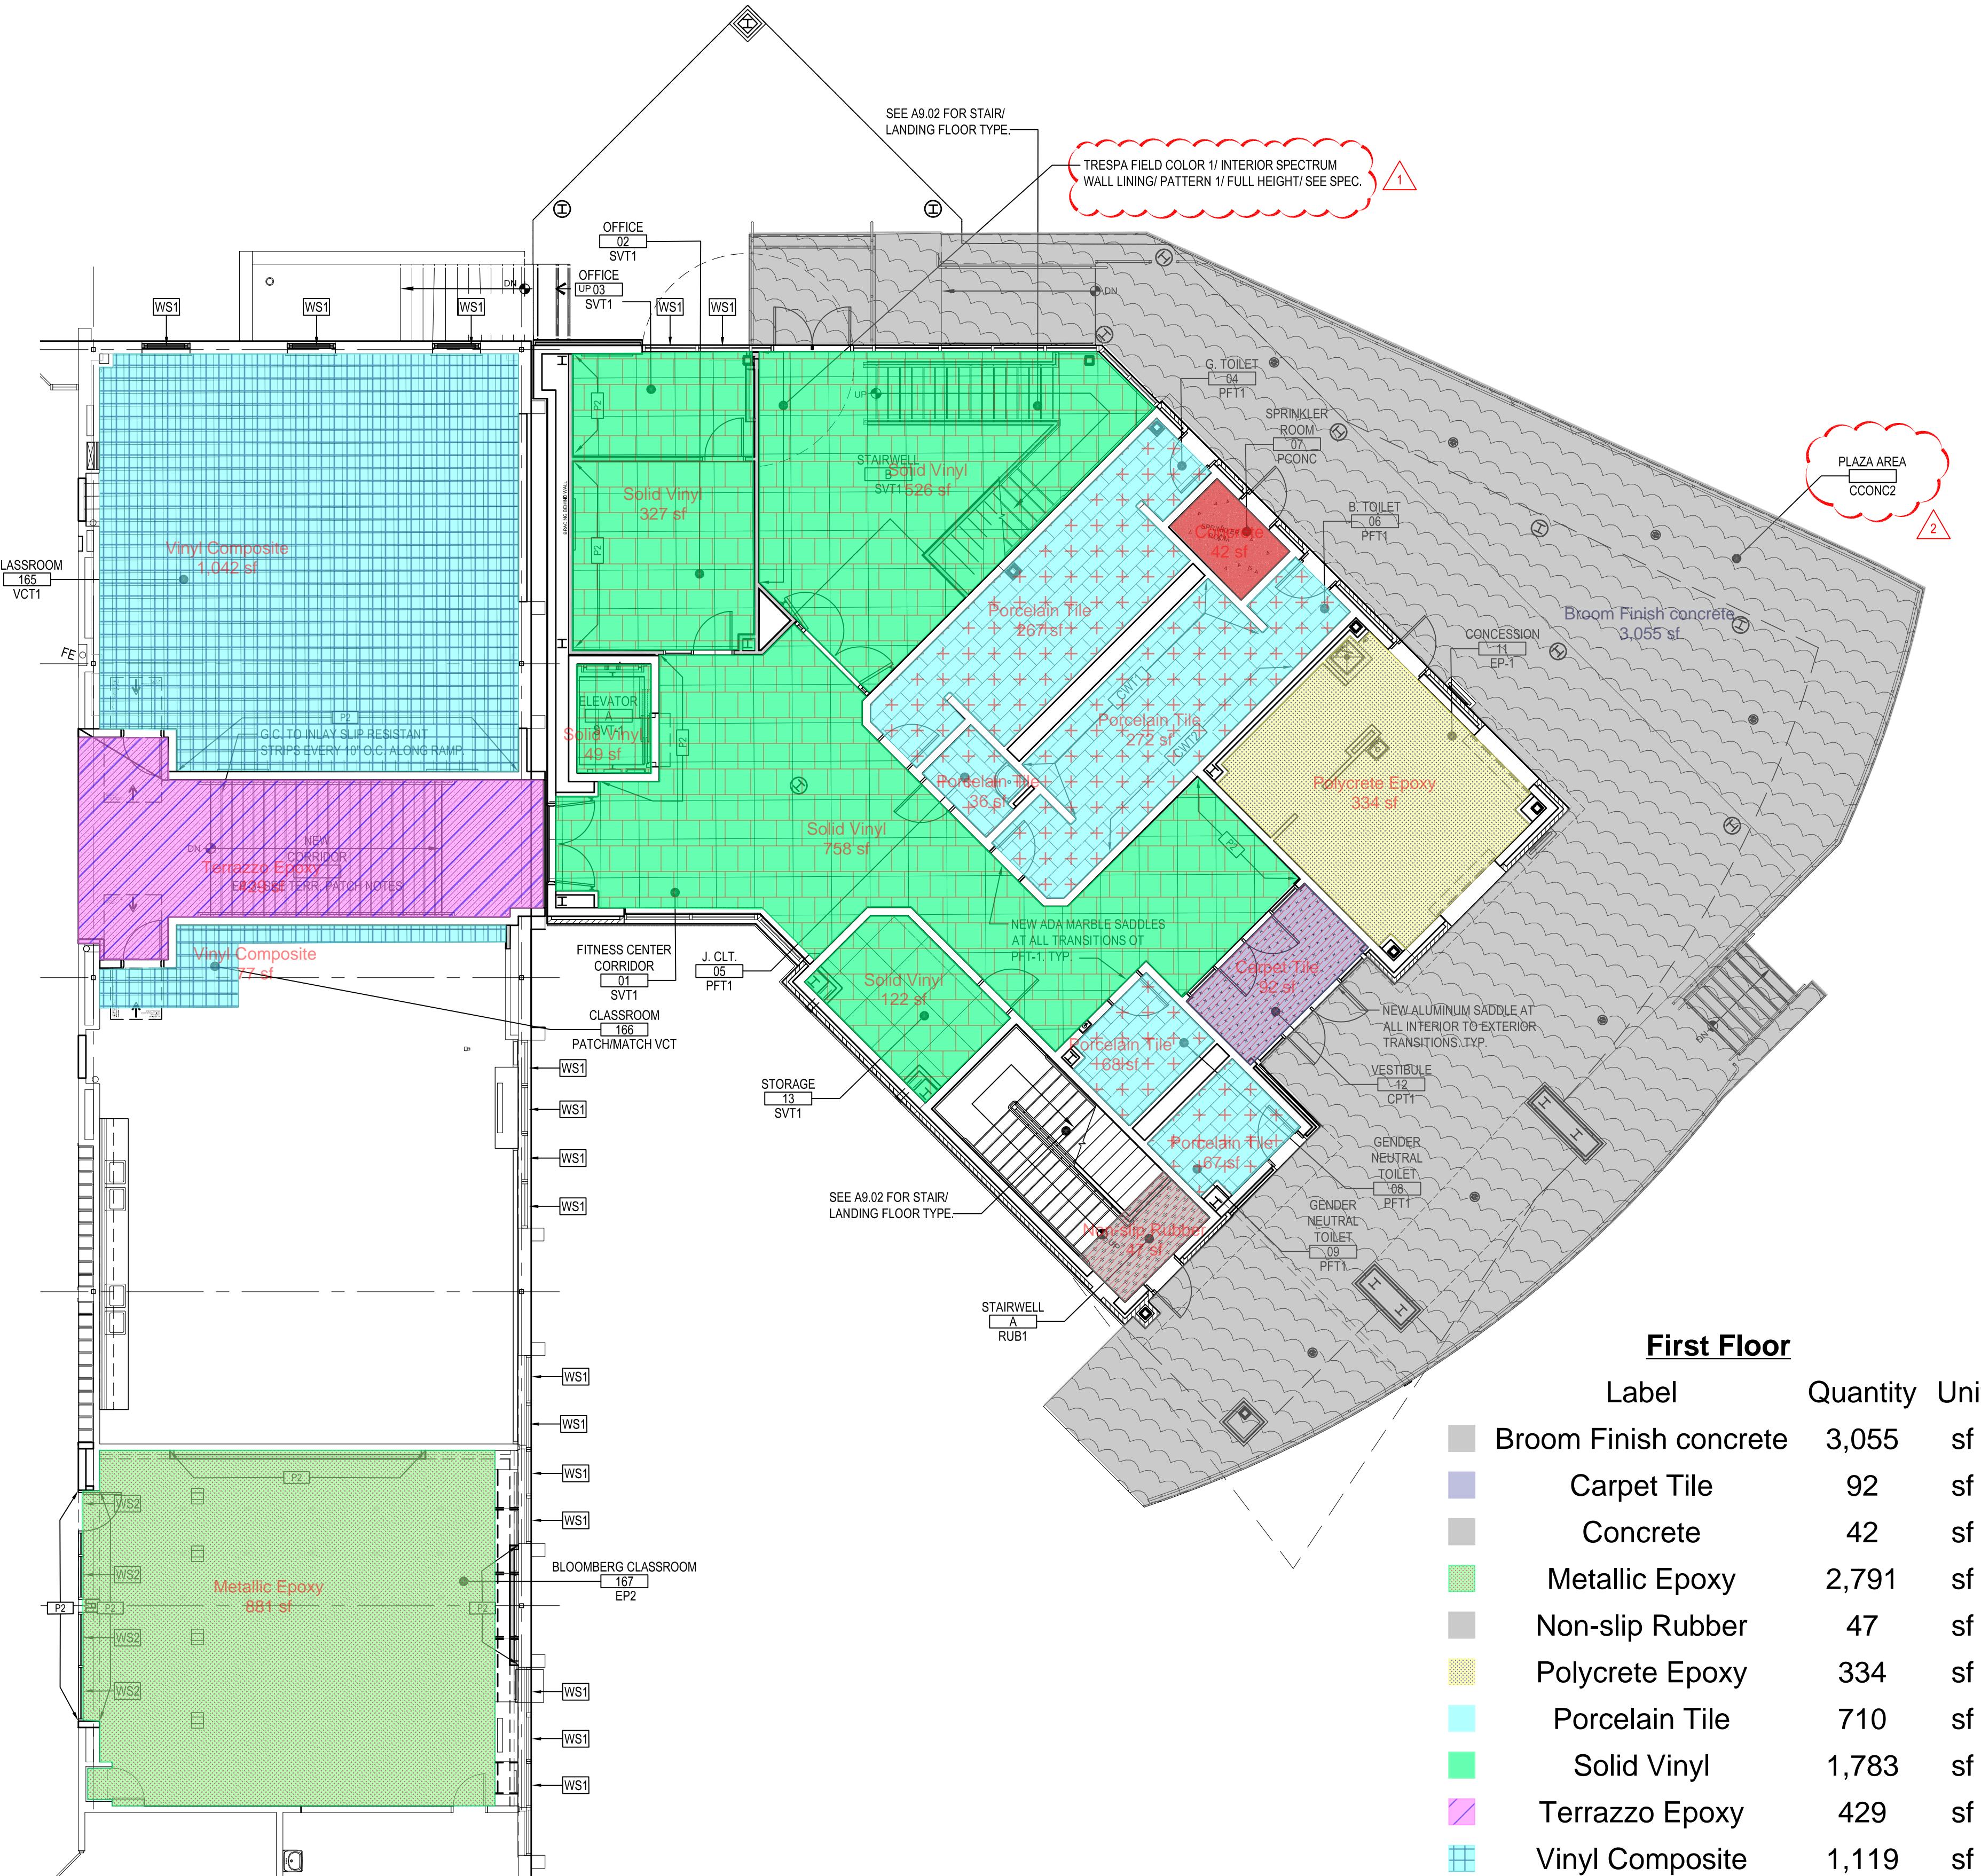


SYMBOLS LEGEND	
CARPET TILE	DESCRIPTION
VINYL COMPOSITE TILE	
SOLID VINYL TILE	
RUBBER	
PREMIUM VINYL FLOORING	
PAINTED CONCRETE	
EPOXY	
EPOXY TERRAZZO FLOORING	
METHYL METHACRYLATE (MMA) FLOORING	
PORCELAIN FLOOR TILE	
CONCRETE WITH A BROOM FINISH	

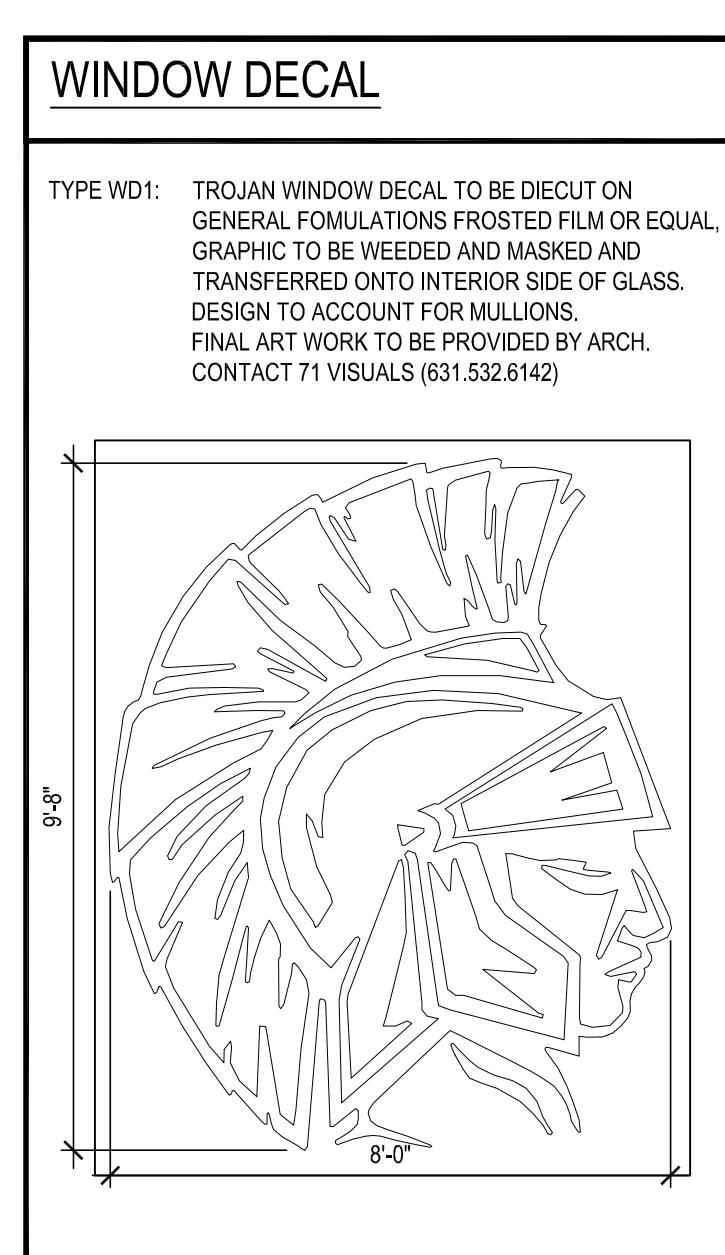


PAINT TYPES	
TYPE P1:	PAINT BY SHERWIN WILLIAMS: EGGSHELL ENAMEL FINISH COLOR: TO BE SELECTED BY ARCHITECT (GENERAL)
TYPE P2:	PAINT BY SHERWIN WILLIAMS: EGGSHELL ENAMEL FINISH COLOR: CRABBY APPLE SW7502 (ACCENT B)
TYPE P3:	PAINT BY SHERWIN WILLIAMS: SEMI-GLOSS ENAMEL FINISH COLOR: TO BE SELECTED BY ARCHITECT (ACCENT B)
TYPE P4:	PAINT BY SHERWIN WILLIAMS: SEMI-GLOSS ENAMEL FINISH COLOR: TO BE SELECTED BY ARCHITECT (HM DOOR FRAMES)
TYPE P5:	PAINT BY SHERWIN WILLIAMS: FLAT ENAMEL FINISH COLOR: WHITE (GYP. DB SOFFIT AND CEILINGS)
TYPE P6:	PAINT BY SHERWIN WILLIAMS: WATERBORN ACRYLIC CRYSTAL FLAT COLOR: AS SELECTED BY ARCH (DECK & STRUCTURE AT 2ND FL. FITNESS CENT.)
TYPE P7:	PAINT BY SHERWIN WILLIAMS: WATERBORN ACRYLIC CRYSTAL FLAT COLOR: AS SELECTED BY ARCH (EXPOSED DUCT WORK AT FITNESS CENT.)

TERRAZZO PATCH NOTES	
1.	GENERAL CONTRACTOR IS REQUIRED TO PATCH ALL AREAS OF FLOOR AND BASE DAMAGED BY CONSTRUCTION.
2.	G.C. IS REQUIRED TO PATCH TERRAZZO FLOOR AND BASE TO MATCH EXISTING AT ALL NEW FLOOR RECESSES AS INDICATED ON THE FINISH FLOOR PLANS.
3.	GENERAL CONTRACTOR SHALL PROVIDE SAMPLES OF TERRAZZO FOR APPROVAL. BINDER COLOR, AGGREGATE TYPE, SIZE, COLOR AND DENSITY SHALL ALL BE MATCHED TO EXISTING AS CLOSELY AS POSSIBLE.
4.	TERRAZZO WALL BASE AT RECONSTRUCTION ARE TO BE INTEGRAL AND MATCH EXISTING PROFILE AND SIZE.
5.	GENERAL CONTRACTOR SHALL MATCH EXISTING CONDITION TERRAZZO FLOOR DIVIDER STRIPS IN SIZE, COLOR AND FINISH.

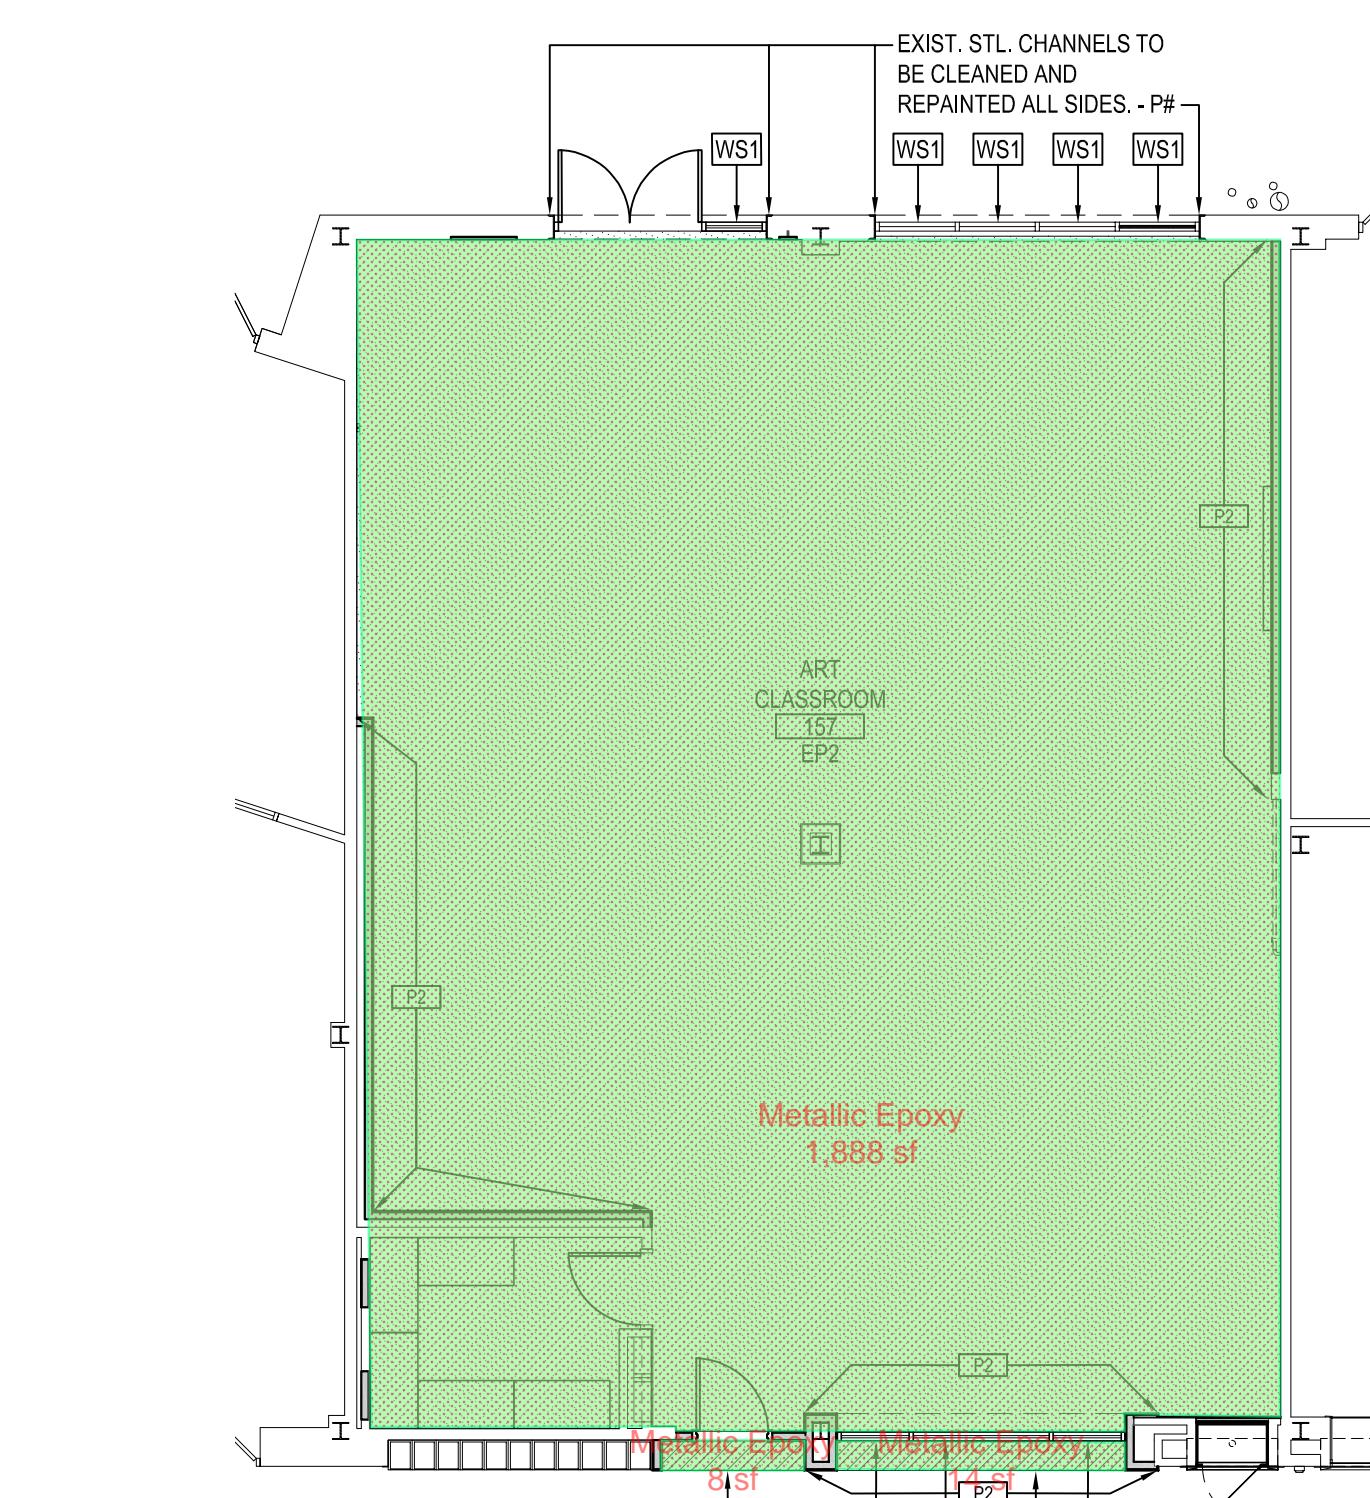

REV.	DATE	ITEM
01	03/28/25	BID ADD. NO. 01
02	03/28/25	BID ADD. NO. 02


NOTICE
THESE DRAWINGS ARE BASED ON CONSTRUCTION DRAWINGS NOT PREPARED BY BBS ARCHITECTS, LANDSCAPE ARCHITECTS AND ENGINEERS. THE DRAWINGS ARE PROVIDED AS A GUIDE ONLY. ALL EXISTING CONDITIONS SHOWN ARE BEING PROVIDED AS IS. NO WARRANTY IS PROVIDED. INFORMATION CONTAINED HEREIN HAVE BEEN BUILT AND DESIGNED PER THE ORIGINAL DOCUMENTS OR PER THE OWNER'S INFORMATION.

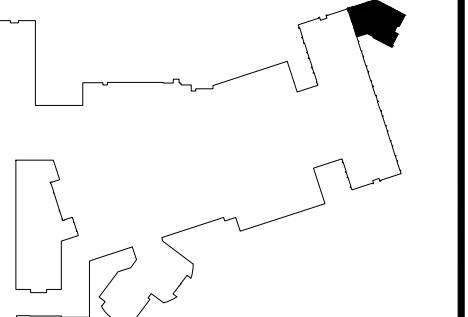

KEY PLAN
NOT TO SCALE

GARDEN CITY UNION FREE SCHOOL DISTRICT
ADDITIONS AND ALTERATIONS
GARDEN CITY HIGH SCHOOL
GARDEN CITY, NASSAU COUNTY, NEW YORK

SECOND FLOOR FINISH PLANS
AND GENERAL NOTES

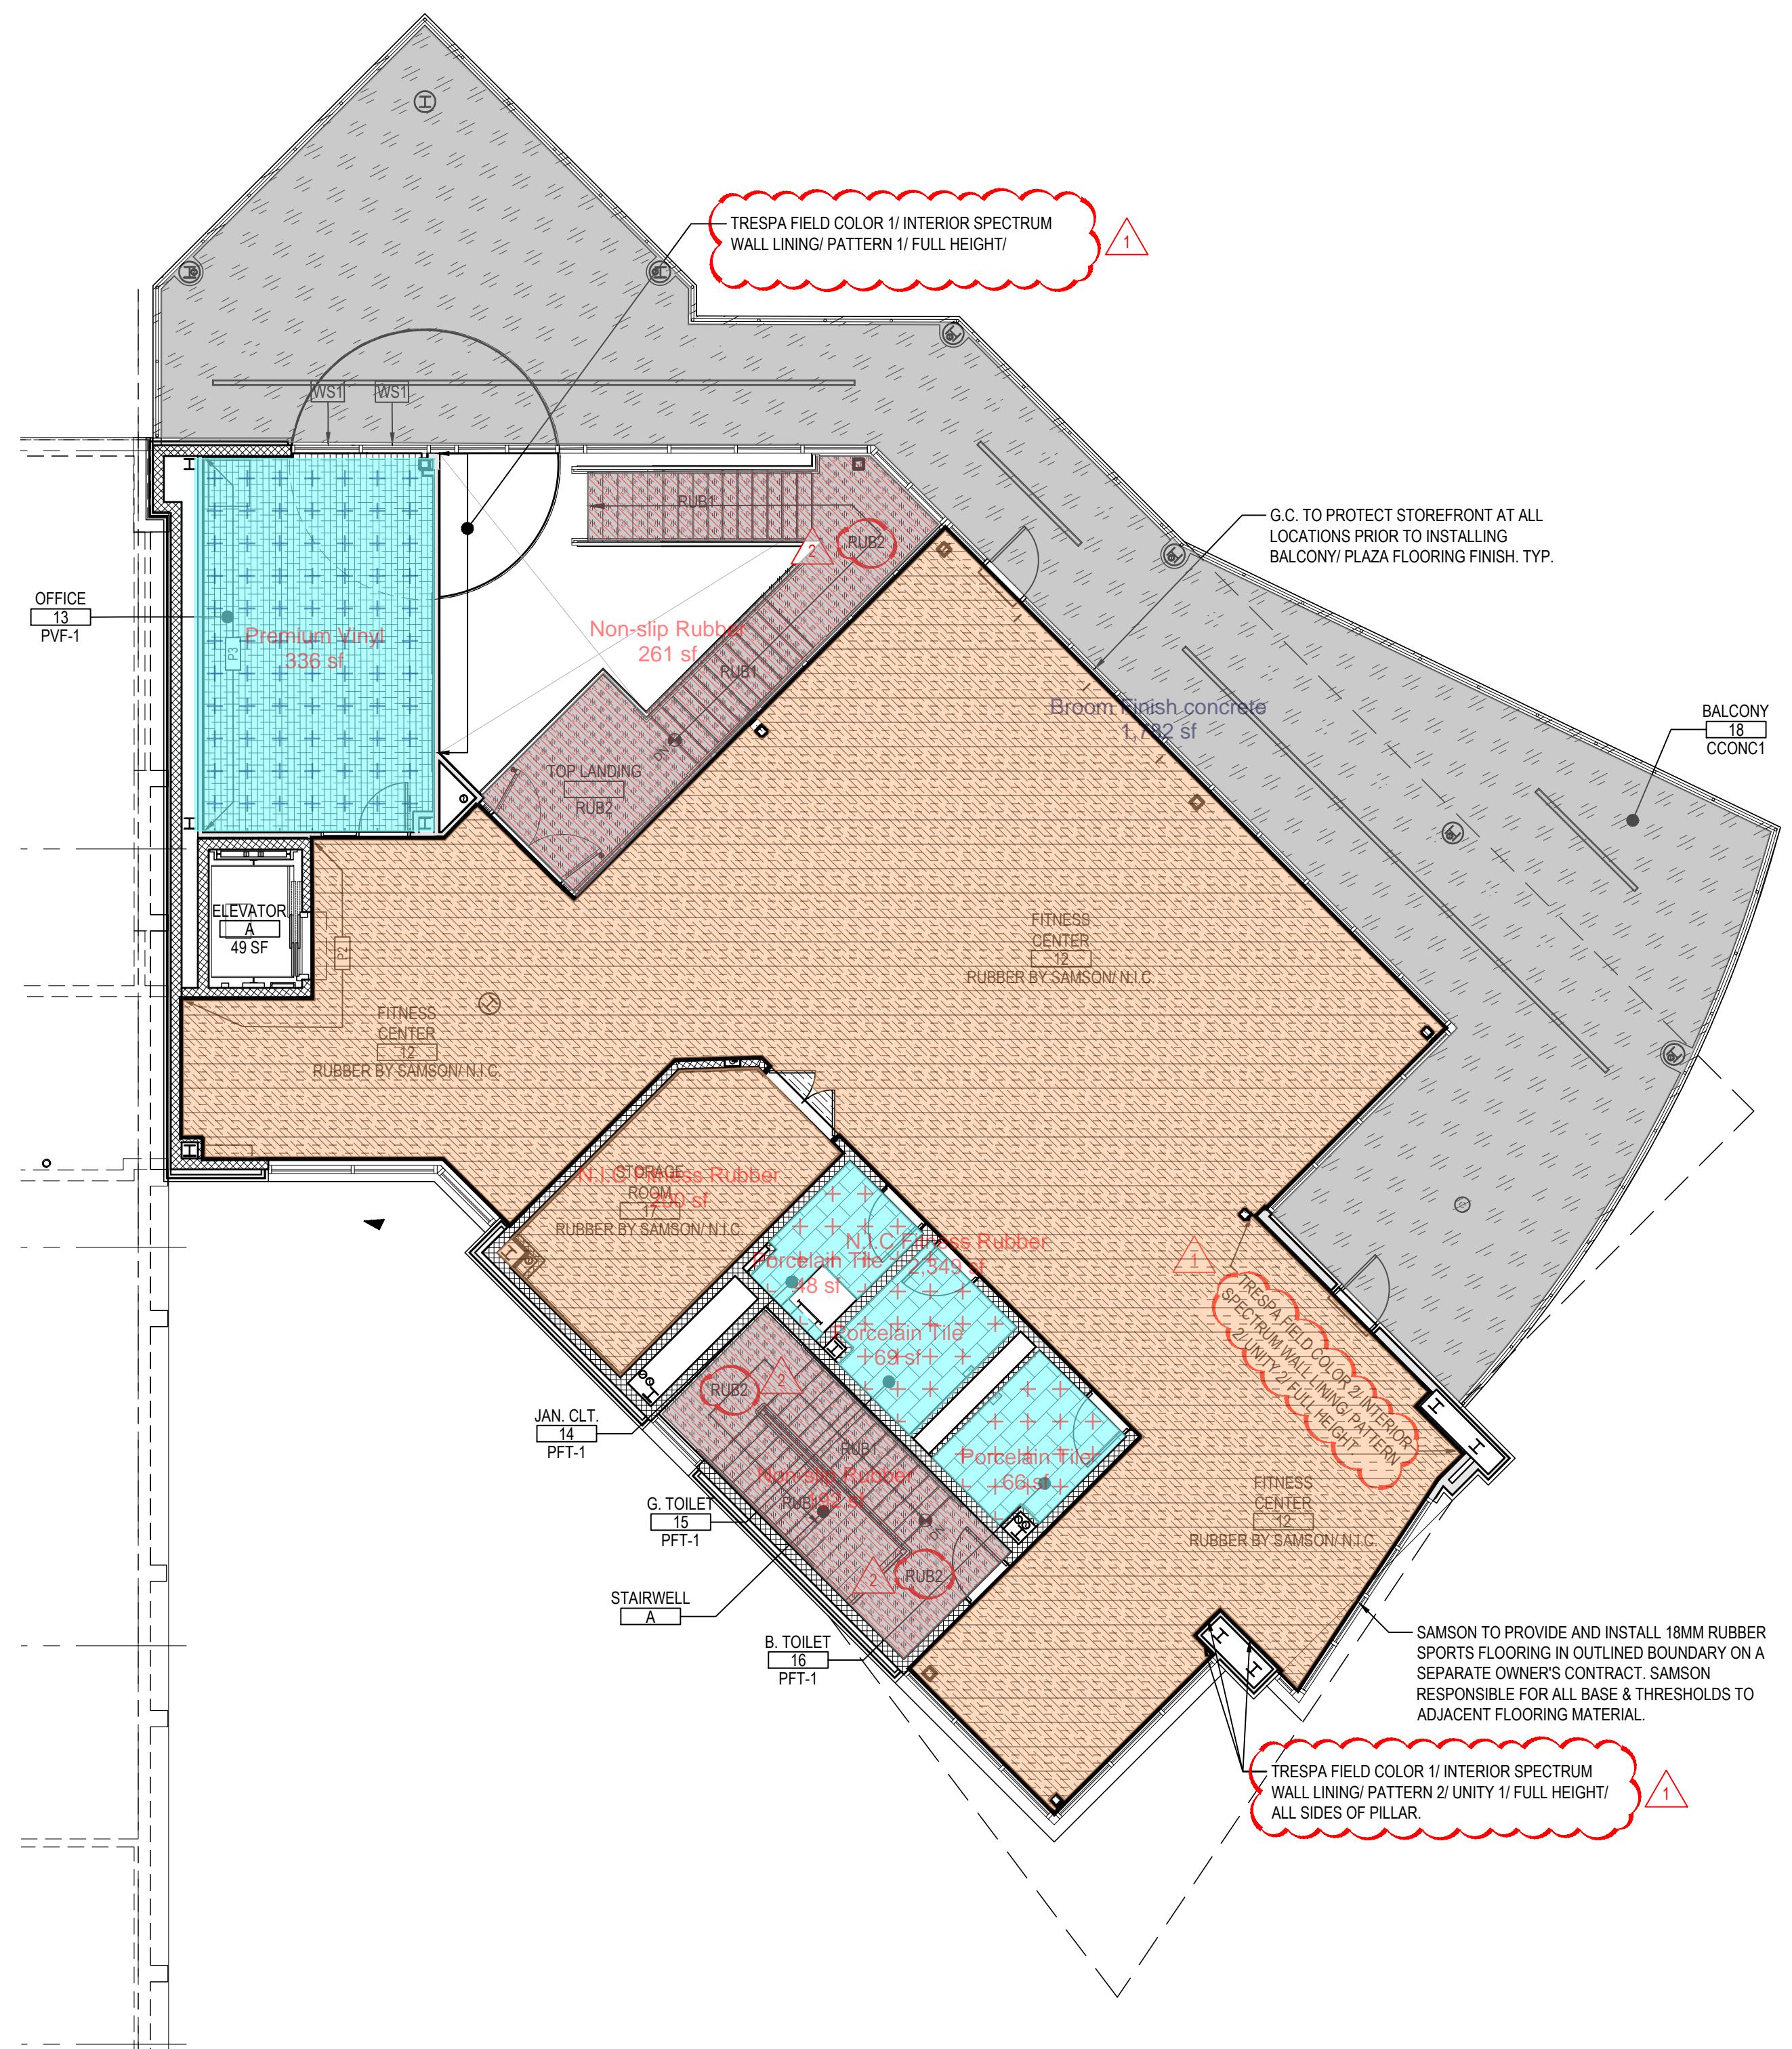

PARTIAL SECOND FLOOR FINISH PLAN - FITNESS CENTER

NOTE:

SYMBOLS LEGEND	
SOLID	CARPET TILE
DIAGONAL Hatching	VINYL COMPOSITE TILE
Horizontal Hatching	SOLID VINYL TILE
Vertical Hatching	RUBBER
Diagonal Hatching	PREMIUM VINYL FLOORING
Horizontal Hatching	PAINTED CONCRETE
Vertical Hatching	EPOXY
Diagonal Hatching	EOXY TERRAZZO FLOORING
Horizontal Hatching	METHYL METHACRYLATE (MMA) FLOORING
Brick Pattern	PORCELAIN FLOOR TILE


Second Floor

Quantity	Unit	Label
1,782	sf	Broom Finish concrete
2,149	sf	Metallic Epoxy
2,549	sf	N.I.C Fitness Rubber
40	sf	Terrazzo Epoxy
183	sf	Porcelain Tile
336	sf	Premium Vinyl
453	sf	Non-slip Rubber

FINISH SCHEDULE								
AREA	ROOM No.	LOCATION	FLOORS		WALLS		REMARKS	ROOM No.
			FIELD	ACCENT	BASE	TYPE		
157	ART CLASSROOM 157		EP2	--	RCB2	GYP	P1/P2	157
165	CLASSROOM 165		VC1	--	RCB2	GYP	P1/P2	165
166	CLASSROOM 166		ETR/PATCH/MATCH VCT		--	MATCH	CMU/GY.	166
~	BLOOMBERG CLASSROOM 167		EP2	--	RCB2	GYP	P1/P2	167
	NEW CORRIDOR		EP3	--	INTERGRAL	CMU	P1/P2	SEE TERRAZZO PATCH NOTES, PROVIDE SLIP RESISTANT STRIPS
01	FITNESS CENTER CORRIDOR	SVT1	--	RCB3	CMU/GY.	P1/P2		01
02	OFFICE 02	SVT1	--	RCB3	GYP	P1/P2		02
03	OFFICE 03	SVT1	--	RCB3	GYP	P1/P2		03
~	ELEVATOR A	SVT1	--	RCB3	SEE SPEC	SEE SPEC		~
04	STARWELL B	SVT1 (RUB1/RUB2 ON STAIR)	--	RCB3	CMU/GY.	P1/P2	SEE PLAN FOR HPL ACCENT WALL LOCATION-FULL HEIGHT	~
05	GIRL'S TOILET	PFT1	--	SCH1	CMU	CWT1/CWT2	SEE A11.04 FOR TILE PATTERN	04
06	BOY'S TOILET	PFT1	--	SCH1	CMU	CWT1 TO 5A.F.P2	SCH2 AT TOP COURSE-PAINT P2 ABOVE	06
07	SPRINKLER ROOM 07	PCONC	--	SCH1	CMU	CWT1/CWT2		07
08	GENDER NEUTRAL TOILET	PFT1	--	SCH1	CMU	CWT1/CWT2		08
09	GENDER NEUTRAL TOILET	PFT1	--	SCH1	CMU	CWT1/CWT2		09
11	CONCESSION	EPI	--	RCB3	CMU	P1		11
12	VESTIBULE	OPT1	--	RCB3	CMU	P1		12
~	STARWELL A	RUB1/RUB2	--	RCB3	CMU	P1		~
13	STORAGE	SVT1	--	RCB3	CMU	P1		13
~	PLAZA	CCONC2	--	--	--	--		~
205	PHYSICS LAB 205	EP2	--	RCB2	GYP	P1/P2	PATCH/MATCH TERRAZZO AT CORRIDOR RECESSES	205
207	PHYSICS LAB 207	EP2	--	RCB2	GYP	P1/P2	PATCH/MATCH TERRAZZO AT CORRIDOR RECESSES	207
12	FITNESS CENTER	N.I.C.	--	N.I.C.	CMU	P1/P2/HPL	PAINT OPEN CEILING/STRUCTURE P6/ PAINT EXPOSED DUCTS P7	12
13	OFFICE	PVF-1	--	RCB3	GYP	P1/P3		13
14	JANITOR CLOSET	PFT1	--	SCH1	CMU	CWT1 TO 5A.F.P2	SCH2 AT TOP COURSE- PAINT P2 ABOVE	14
15	GIRL'S TOILET	PFT1	--	SCH1	CMU	CWT1/CWT2		15
16	BOY'S TOILET	PFT1	--	SCH1	CMU	CWT1/CWT2		16
17	STORAGE ROOM	N.I.C.	--	N.I.C.	CMU	CWT1/CWT2		17
18	BALCONY	CCONC1	--	--	--	--		18

BBS
ARCHITECTS
LANDSCAPE ARCHITECTS
ENGINEERS

244 EAST MAIN STREET
PATCHOGUE
NEW YORK 11772
T. 631.475.3600
F. 631.475.3661
www.bbsarchitecture.com

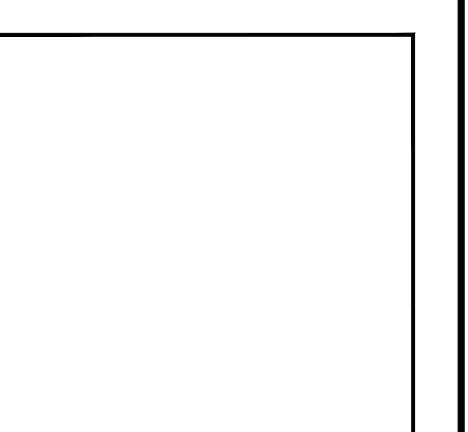

SED No. 28-02-18-03-0-007-034
DISTRICT GARDEN CITY UNION FREE SCHOOL DISTRICT
PROJECT GARDEN CITY HIGH SCHOOL ADDITIONS AND ALTERATIONS
DWG TITLE PARTIAL SECND FLR FINISH PLANS
SCALE AS NOTED
DATE MARCH 6, 2025
BID PICK-UP MARCH 6, 2025
FILE No. 24-145

